
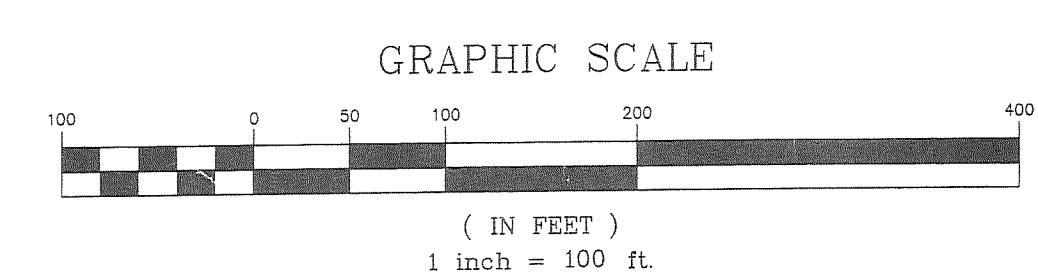


SEWER AS-BUILTS AT AMENDED HIGHLAND MEADOWS PUD

LOCATED IN SECTION 1, TOWNSHIP 6 SOUTH, RANGE 78 WEST OF THE 6TH PRINCIPAL MERIDIAN
SUMMIT COUNTY, COLORADO

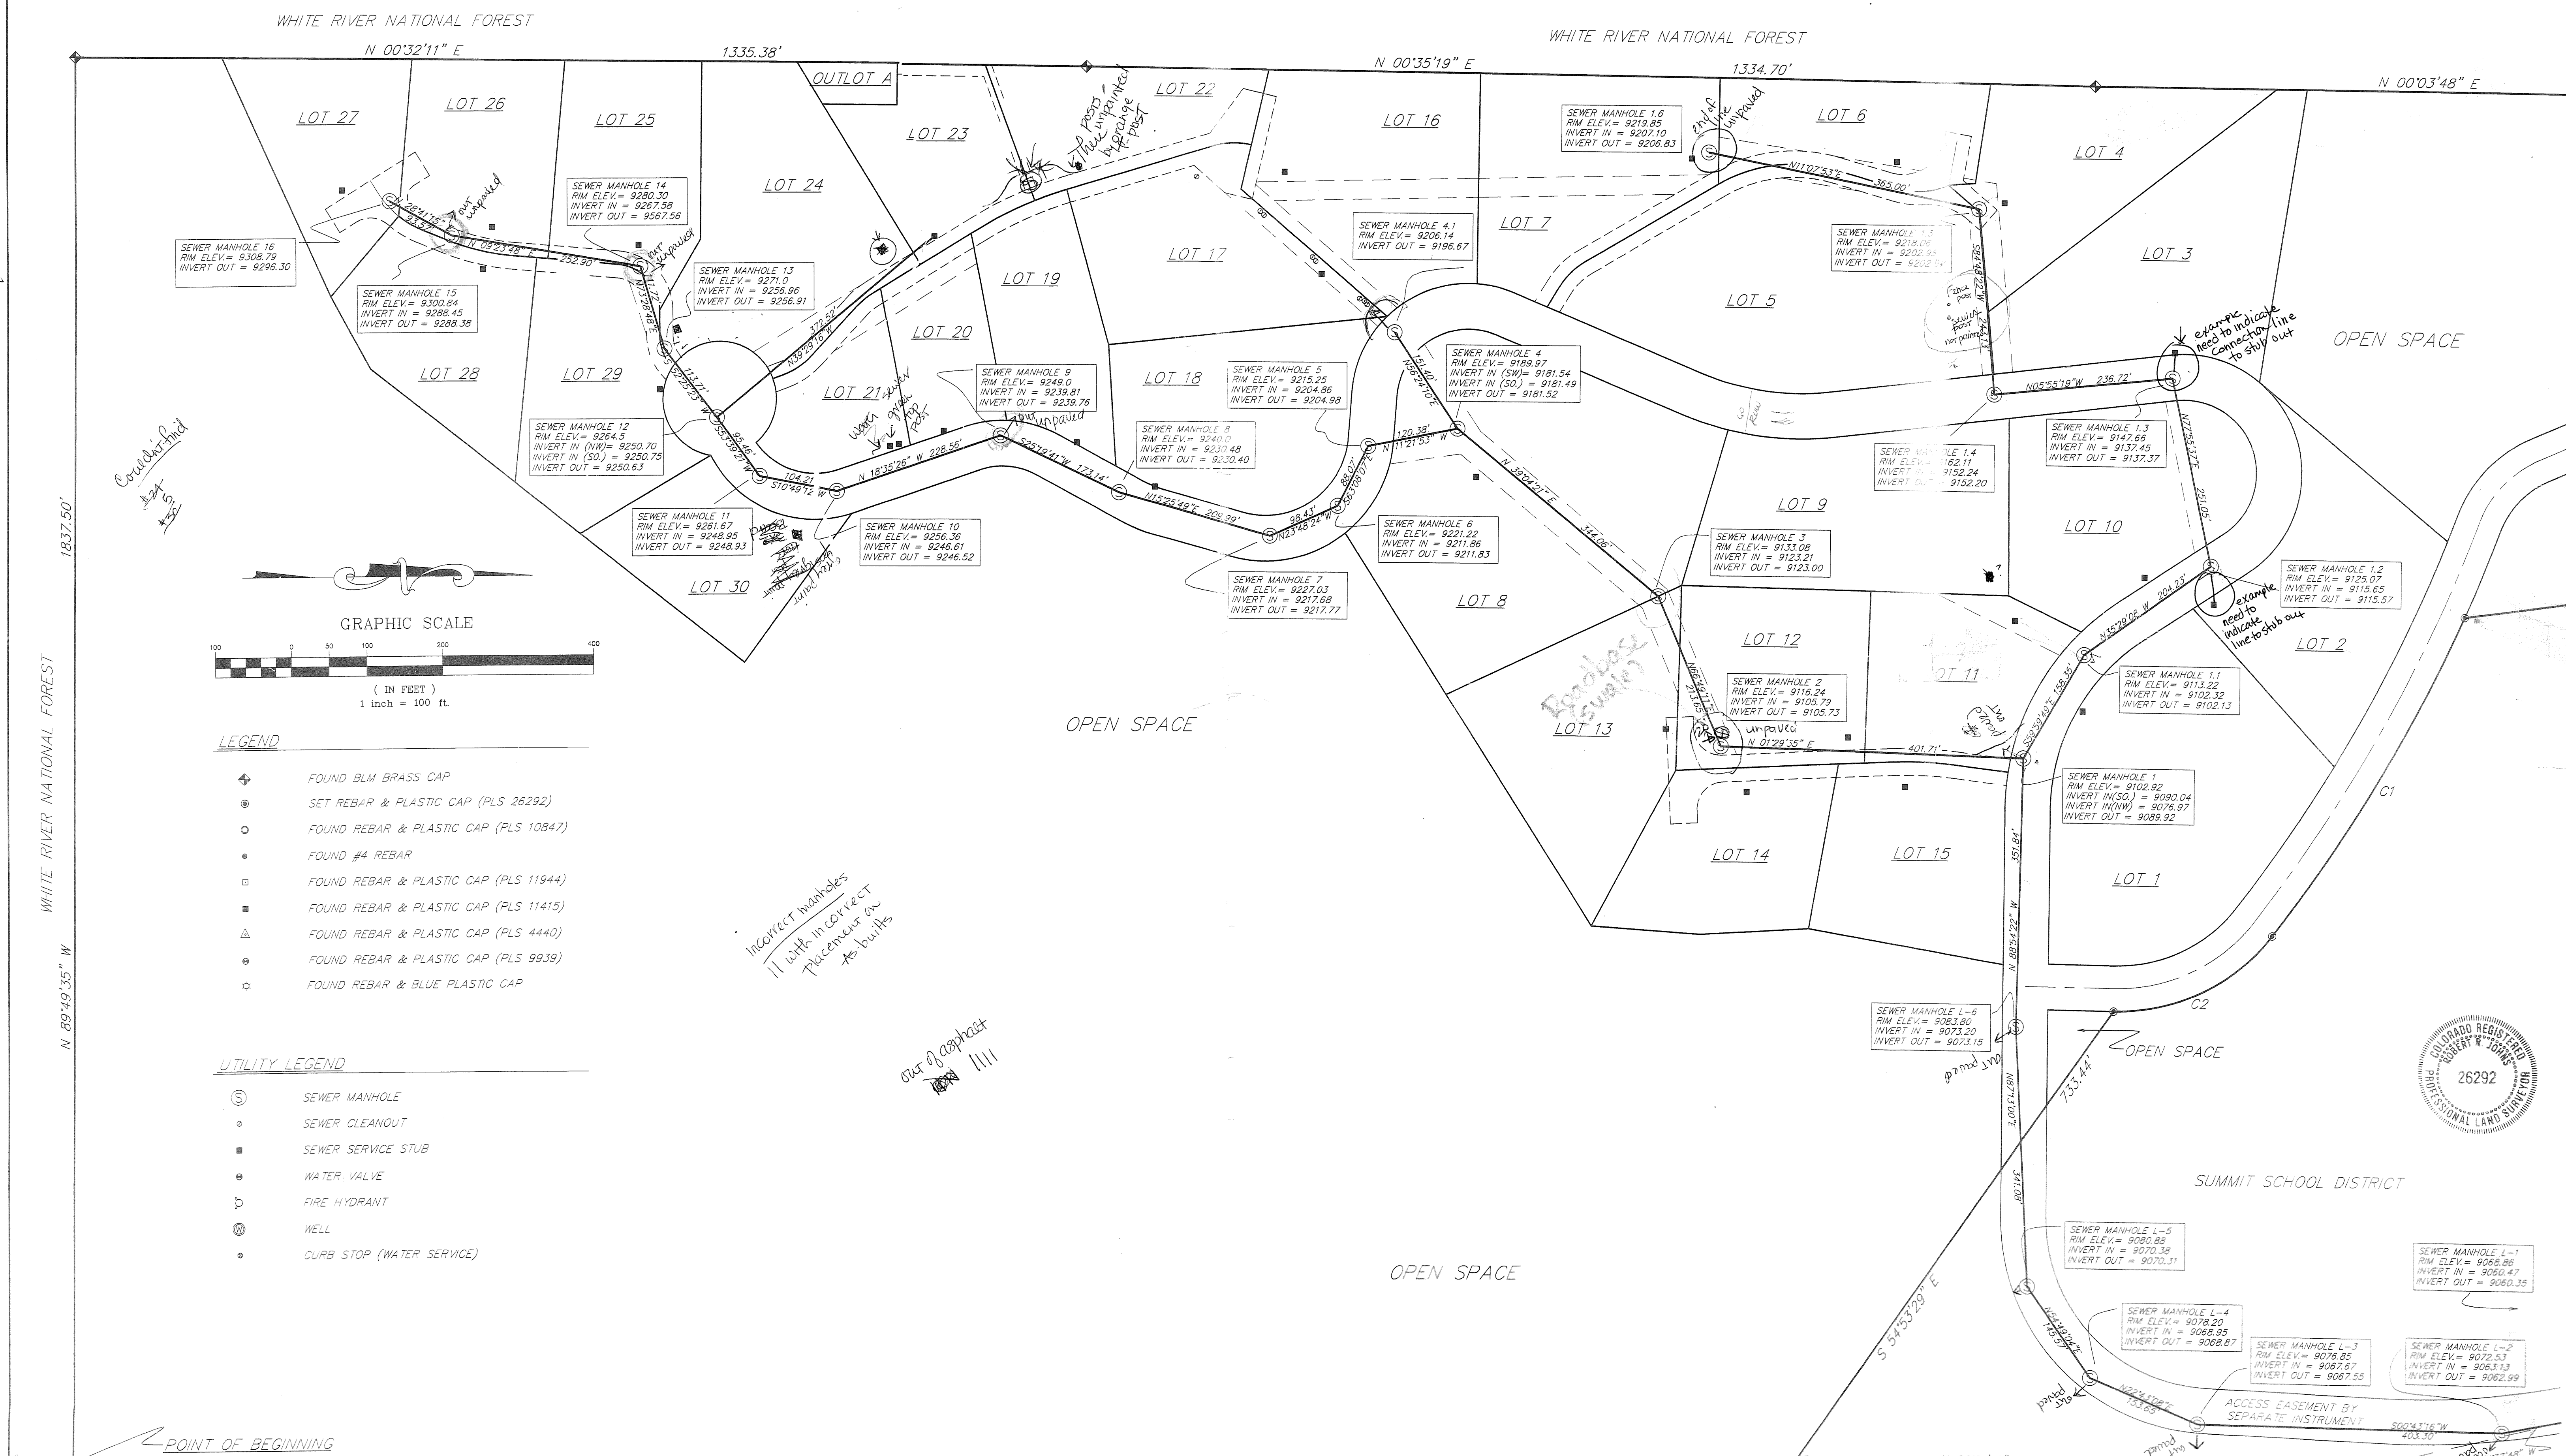

- LEGEND**
- ◆ FOUND BLM BRASS CAP
 - SET REBAR & PLASTIC CAP (PLS 26292)
 - FOUND REBAR & PLASTIC CAP (PLS 10847)
 - FOUND #4 REBAR
 - FOUND REBAR & PLASTIC CAP (PLS 11944)
 - FOUND REBAR & PLASTIC CAP (PLS 11415)
 - △ FOUND REBAR & PLASTIC CAP (PLS 4440)
 - ⊙ FOUND REBAR & PLASTIC CAP (PLS 9939)
 - ⊛ FOUND REBAR & BLUE PLASTIC CAP

- UTILITY LEGEND**
- ⊙ SEWER MANHOLE
 - SEWER CLEANOUT
 - SEWER SERVICE STUB
 - WATER VALVE
 - ⊕ FIRE HYDRANT
 - ⊙ WELL
 - CURB STOP (WATER SERVICE)



Drawn R/W/ES	Dwg ASBUILTS	Project 16155
Checked	Date 11/08/01	Sheet 1 of 1

V:\PROJECTS\ASBUILTS 15 - 11-08-2001 RANGE WEST, INC. (R/W)